



Product Change Notification

TE Connectivity

Product Change Notification: E-21-001241

PCN Date: 15-FEB-21

TE would like to inform you of the following change(s) to the listed TE Connectivity Product. In case of any further questions about this change(s), please contact your TE Connectivity Sales Engineer. Affected part, drawing and/or specification numbers are listed on the attached sheet(s).


General Product Description:

DEUTSCH SRK Series, 8mm Dia Contacts, Inspection Hole Change

Description of Changes

The Industrial and Commercial Transportation business unit of TE Connectivity is making a change to the inspection hole from one side to two sides for the part number(s) listed below. These PNs are TE proprietary designs, therefore considered catalog/general market product. PPAP and/or sample requests must be submitted within 14 days of PCN submission via ict-ppap-request@te.com or ePPAP system. Submission will not occur without request. If PPAP requested, disposition response is required within 14 days of submit date or it will be considered approved. Product drawing(s) is affected.

BEFORE AND AFTER PICTURE

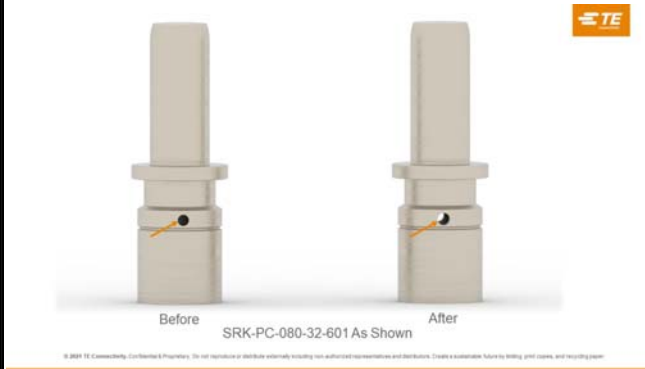

Other attachments:

[CUSTOMER DRAWING MARKUP](#)

Reason for Changes:

Manufacturing / Process Requirements. Dear Customer, we hereby inform you of this change. The change is necessary to meet the suppliers process workflow. The change does not impact performance. IMPORTANT: The current and previous revisions of these parts can be used interchangeably in the field. The change(s) are being phased in gradually and previous revision can remain stocked until use. Shipments of both configurations may be mixed.

Estimated Dates:

Last Order Date (Obsolete Parts Only):	First Date To Ship (Changed Parts Only):
	17-MAY-2021
Last Ship Date (Obsolete Parts Only):	Last Date for Mixed Shipments: (Changed Parts Only):
	17-AUG-2022

Part Number(s) being Modified:

Part Number	Part Discontinued per PCN	Customer Drawing	Customer Part Number	Alias Part Number (s)	Substitute Part Number	Substitute Alias Part Number(s)	Description Of Difference
SRK-PC-080-25-601	NO			"9-1899790-2"			
SRK-PC-080-32-601	NO						
SRK-PC-080-35-601	NO			"2-1899774-7"			

The documents listed below are being modified. Related parts that are not explicitly listed on this PCN are not being modified or discontinued as per the PCN. The Last Order Date, Last Ship Date, First Date to Ship Changed Parts and last date for Mixed Shipments apply only to parts explicitly listed on this PCN.

Customer Drawing(s) Being Modified:

Drawing Number	Related Part Number	Customer Part Number	Current Revision	New Revision
SRK-PC-080-16/35-XX	SRK-PC-080-25-601		A1	

